

Appendix B

Exhibit A


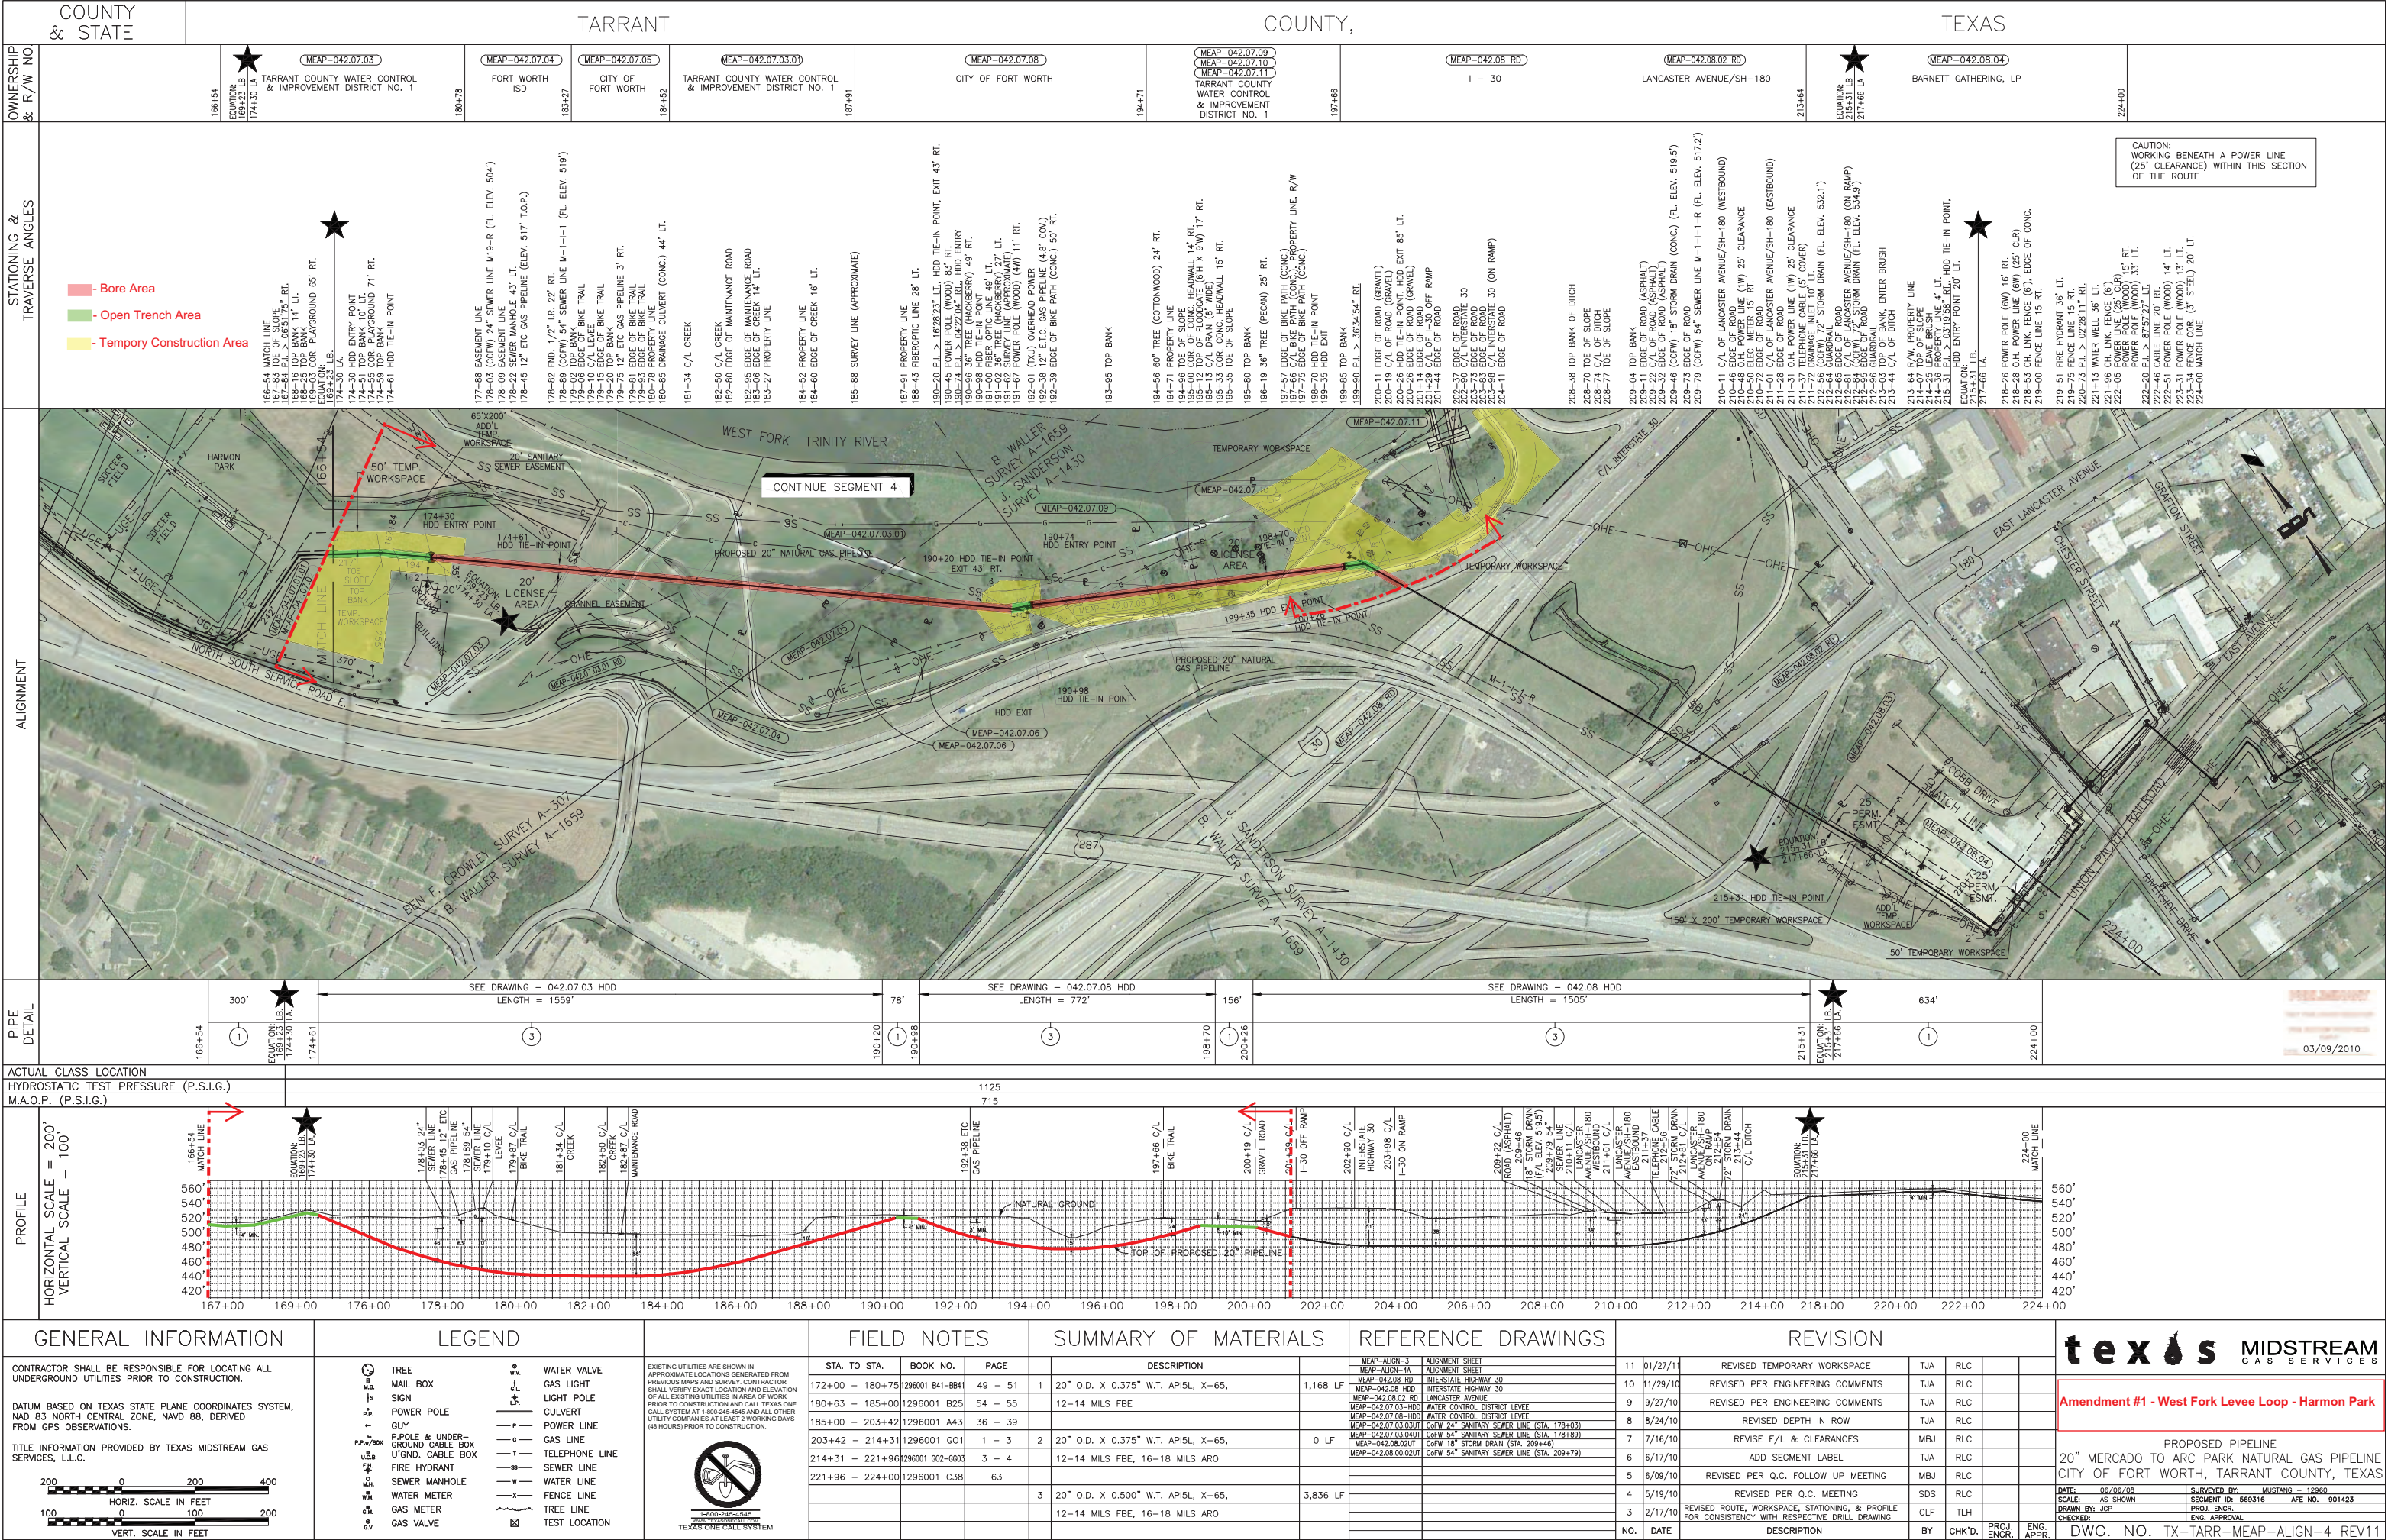


Exhibit B

TARRANT COUNTY, TEXAS
B. F. CROWLEY SURVEY, A-307



PLAN

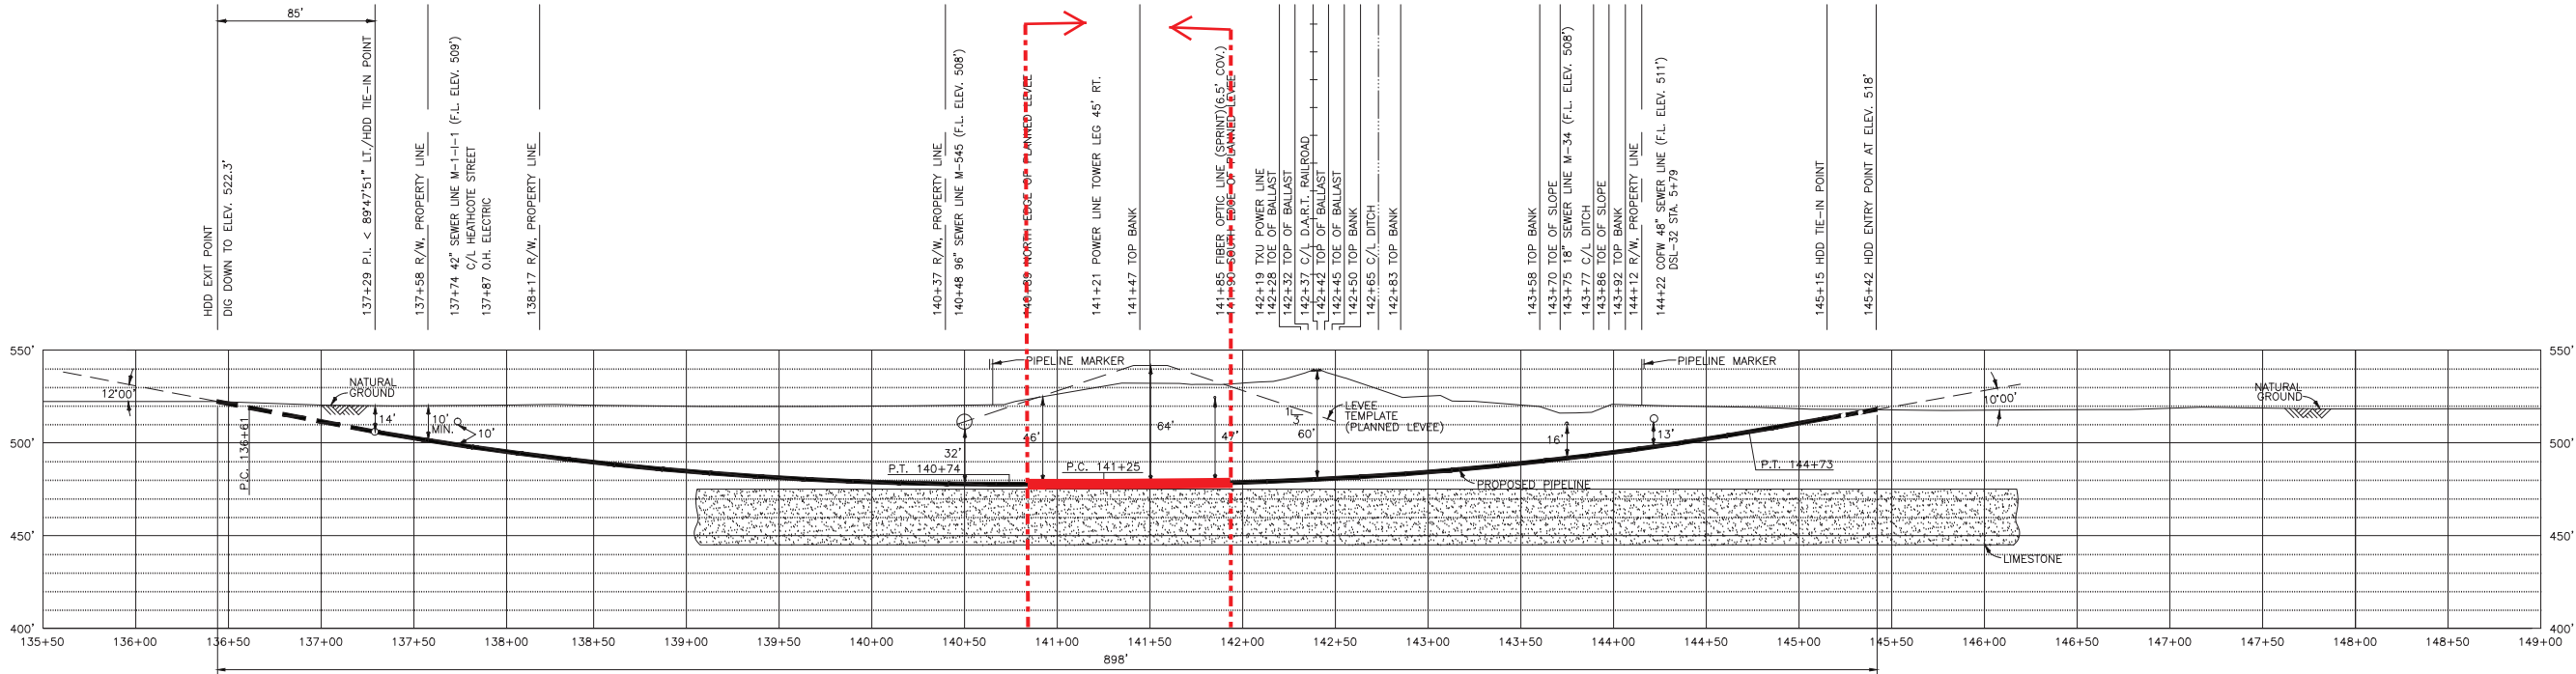

NOTES:

- All welds are 100% X-Rayed. (Per AREMA 5.1.6.3)
- All welded joints are sandblasted, heated to 160 degrees & the matching epoxy kit, per factory pipe coating, is applied.
- The pipe is electrically tested "jeeped" for coating imperfections.
- Two types of factory coating are used in the industry.
 - F.B.E. "Fusion Bonded Epoxy" is used on open ditch applications. This coating is very durable but pliable.
 - ARO coating is used in H.D.D. "Horizontal Directional Drill" applications. The pipe is first coated with F.B.E. and then coated with ARO, which makes the coating pliable but impervious to scraps and scratches caused by rocks.
- After the pipeline section is assembled, test heads are welded on both ends and hydrostatically tested to 1.5 times the M.A.O.P., Maximum Allowable Operating Pressure, for 8 hours with a "Deadweight Chart Recorder". The chart is then filed in the "Closing Package" of that project. (Per AREMA 5.1.6.3)
- H.D.D. pipe = 20" O.D. x 0.500" W.T., API 5L X-65, 12-14 Mils FBE, W 16/18 Mils ARO.
- Sacrificial anodes are used for temporary cathodic protection until the completed pipeline system is engineered for a rectified, 24 volt D.C. system with anode beds. D.O.T. requires an annual inspection of pipeline cathodic protection systems, but TMGS inspection requirements are bi-annual. No Dart above ground facilities are in the area. (Per AREMA 5.1.6b)
- Per the DART railroad and TMGS pipeline, hydrostatic testing exceptions will be made to insure the safety of the DART railway system. The working pressure of this pipeline system is estimated to be 325 psig to 550 psig when the system is flowing to the Arc Park Compressor Facility. TMGS will set their hydrostatic test M.A.O.P. at 715 psig thus making the actual maximum testing pressure 1,125. (Per AREMA 5.1.6.3)
- The pipe to be installed under said DART project is 20" O.D., 0.500" wall thickness, X-65 yield strength, 2,600 psi mill tested and 100% SMYS is 65,000 psi.

CURVE DATA (EXIT)
D = 12'00'00"
R = 2000'
T = 418.9'
T = 210.2'

DATUM BASED ON TEXAS STATE PLANE COORDINATES SYSTEM, NAD 83 NORTH CENTRAL ZONE, NAVD 88, ELEVATIONS MSL, DERIVED FROM GPS OBSERVATIONS.

CURVE DATA (ENTRY)
D = 10'00'00"
R = 2000'
T = 349.00'
T = 175.00'

50' 0 50'
HORIZ. & VERT. SCALE IN FEET

20" HDD under Ham Branch Levee, Lower West Fork (MEAP)
and
8" HDD under Ham Branch Levee, Lower West Fork (Westgate)
(parallel pipelines, lateral spacing approx 20')

REV	DATE	BY	DESCRIPTION	CHK	ENGR	APPR	CLIENT
11	02/11/11	TJA	REVISED WORKSPACE	RLC			
10	01/26/11	TJA	REVISED WORKSPACE, HDD ENTRY/EXIT	RLC			
9	12/30/10	TJA	REVISE PER ENGINEERING MARKUP	RLC			
8	09/27/10	TJA	REVISE PER ENGINEERING COMMENTS	RLC			
7	07/16/10	MBJ	REVISE HDD PROFILE	RLC			
6	06/17/10	TJA	ADD SEGMENT NAME	RLC			
5	05/18/10	HLM	REVISED PER Q.C. MEETING/ADD LEEVE TEMPLATE	RLC			
4	03/09/10	TJA	REVISED STATIONING	RLC			



1-800-245-4545
WWW.TEXASONECALL.COM
TEXAS ONE CALL SYSTEM

PROJECT NO.	12960	SEGMENT ID:	569316
DESIGNED BY			
DRAWN BY	RSH	03/07/08	
CHECKED BY	CPD	07/03/08	
APPROVED BY			
SCALE	1"= 50'	DATE	

texas MIDSTREAM
GAS SERVICES

PROPOSED MERCADO TO ARC PARK PIPELINE
SEGMENT 4 - 4TH ST. C.F. TO ALVARADO V.S.
HDD PLAN & PROFILE
DART RAILROAD
TARRANT COUNTY, TEXAS

DWG. NO. TX-TARR-MEAP-042.01 HDD

REV. 11

COUNTY & STATE

TARRANT

COUNTY,

TEXAS

OWNERSHIP & R/W NO.

MEAP-001.00
MEAP-001.00.00.01
CHESAPEAKE EXPLORATION, L.P.
EQUATION: 31+78 LA 31+59 LA 1+49

MEAP-001.00.01
UNION PACIFIC RAILROAD

MEAP-003.01 RD
NORTHSIDE DRIVE

MEAP-002.00
TARRANT REGIONAL WATER DISTRICT

MEAP-005.02.01
TEXAS ELECTRIC SERVICE COMPANY

MEAP-004.00
LEGEND BANK NA

WEST FORK TRINITY RIVER

MEAP-005.02
TARRANT REGIONAL WATER DISTRICT

MEAP-005.03
CITY OF FORT WORTH

MEAP-005.04
MEAP-005.05
FRANCES ELLEN GINSBURG

MEAP-008.02
CITY OF FORT WORTH

MEAP-005.03.01
CITY OF FORT WORTH

MEAP-008.00
CITY OF FORT WORTH

MEAP-007.00
CITY OF FORT WORTH

MEAP-009.00
HUDSON CONSTRUCTION INC., et al

MEAP-010.00
CHERYL SUE ELLISTON

STATIONING & TRAVERSE ANGLES

0+00 BEGIN SURVEY, FENCE LINE
0+40 CONCRETE SLAB 7' RT. 9' RT.
0+44 CONCRETE SLAB 7' RT. 9' RT.
0+51 P.I. < 3000.00' RT.
1+23 CONCRETE PARKING LOT 26' LT.
1+23 LINE BACK

0+59 LINE AHEAD
1+38 O.H. ELECTRIC, POWER POLE 10' RT.
1+43 GUY WIRE 100' RT.
1+46 FENCE CORNER (4" STEEL PIPE) 100' RT.
1+54 P.I. < 8038.01' LT.
1+77 PARKING LOT (CONC.) 13' LT.
2+16 TMS 24" GAS PIPELINE (ELEV. 506.3' T.O.P.)
3+59 POWER POLE 6' RT. 1' RT.
3+67 P.I. < 0400.32' LT.
3+81 POWER POLE 7' LT.
4+42 FENCE (6" CHAIN LINK)
4+59 FENCE (6" CHAIN LINK)
5+82 BROADWAY FIBER OPTIC CABLE 37' RT.
5+90 HDD EXIT POINT 37' RT.
6+03 GUY ANCHOR, POWER POLE 1' LT.
6+43 GUY ANCHOR, POWER POLE 1' LT.
6+44 BURIED TELEPHONE (2" COV.)
6+51 POWER POLE 20' LT. PARKING LOT 1' RT.
6+56 12" SANITARY SEWER (F/L ELEV. 518)
7+04 O.H. ELECTRIC
7+12 EDGE OF ROAD
7+42 C/L NORTHSIDE DRIVE
7+60 O.H. ELECTRIC
7+75 EDGE OF ROAD
8+51 R/W, PROPERTY LINE
11+01 PROPERTY LINE

13+18 O.H. ELECTRIC
13+32 PROPERTY LINE
13+58 PROPERTY LINE
13+60 EDGE OF WATER
14+96 C/L WEST FORK TRINITY RIVER
16+21 EDGE OF WATER
16+22 O.H. ELECTRIC (TXU)
17+19 EDGE OF ROAD
17+25 C/L GRAVEL ROAD
17+25 TRANSMISSION TOWER 91' RT.
17+31 EDGE OF ROAD
18+07 C/L GRAVEL ROAD
18+19 EDGE OF ROAD
18+64 PROPERTY LINE
18+82 ETC 20" GAS PIPELINE (ELEV. 529' T.O.P.)
19+26 C/L OF LEVEE
21+13 PROPERTY LINE
21+79 ETC 10" GAS PIPELINE (ELEV. 530.7' T.O.P.)
22+03 HDD TIE-IN POINT
22+21 HDD ENTRY POINT
23+07 TOP OF BANK
23+40 SURVEY LINE (APPROXIMATE)
23+52 PROPERTY LINE
24+01 P.I. < 2250.44' LT.
26+26 MANHOLE 10' RT.
26+33 48" COFW SANITARY SEWER (F/L ELEV. 508.9)
29+82 P.I. < 3136.96' LT.
31+04 PROPERTY LINE
31+06 TOP OF BANK
31+78 P.I. < 3000.00' RT.
EQUATION: 31+78 LA 31+59 LA 1+49 LINE AHEAD

34+40 P.I. < 8718.02' LT.
34+84 FENCE CORNER 15' RT.
35+90 HELIPAD CORNER 178' LT.
36+77 POLICE HELIPORT OFFICE 160' LT.
37+28 POLICE HELIPORT OFFICE 160' LT.
38+00 PROPERTY LINE
38+05 P.I. < 7039.00' RT.
38+16 GUY ANCHOR 15' RT.
38+67 GUY ANCHOR 7' RT.
38+93 POWER POLE (WOOD) 7' RT.
39+39 ENTER 60" X 60" ETC METER SITE
39+71 6" TMS GAS PIPELINE (ELEV. 530' T.O.P.)
39+99 EXIT 60" X 60" ETC METER SITE
41+21 PROPERTY LINE
41+33 POWER POLE (WOOD) 7' RT.
41+59 GUY ANCHOR 8' RT.
41+72 P.I. < 4753.00' LT., ELECTRIC METER 11' RT.
41+76 POWER POLE (WOOD) 12' RT.
41+79 GUY ANCHOR 15' RT.
41+95 POWER POLE (WOOD) 13' RT.
42+50 20" X 16" STD. TEE, WE BLOCK VALVE, CAP
42+53 P.I. < 1213.00' RT.
43+38 O.H. ELECTRIC
43+66 FENCE
44+19 FENCE
44+23 POWER POLE 18' LT.
44+29 C/L GRAVEL ROAD
44+64 EDGE OF ROAD
46+63 P.I. < 9000.00' RT.
47+23 PROPERTY LINE
50+00 MATCH LINE

ALIGNMENT

PIPE DETAIL

0+00
1+23
0+59
1+49
1+59
1+69
5+00

614'
1613'
2,816'

HDD-SEE DWG. MEAP-005.00 HDD

ACTUAL CLASS LOCATION
HYDROSTATIC TEST PRESSURE (P.S.I.G.)
M.A.O.P. (P.S.I.G.)

0+00
1+23
0+59
1+49
1+59
1+69
5+00

614'
1613'
2,816'

HDD-SEE DWG. MEAP-005.00 HDD

ACTUAL CLASS LOCATION
HYDROSTATIC TEST PRESSURE (P.S.I.G.)
M.A.O.P. (P.S.I.G.)

PROFILE

HORIZONTAL SCALE = 200'
VERTICAL SCALE = 100'

0+00
1+23
0+59
1+49
1+59
1+69
5+00

614'
1613'
2,816'

HDD-SEE DWG. MEAP-005.00 HDD

ACTUAL CLASS LOCATION
HYDROSTATIC TEST PRESSURE (P.S.I.G.)
M.A.O.P. (P.S.I.G.)

GENERAL INFORMATION

CONTRACTOR SHALL BE RESPONSIBLE FOR LOCATING ALL UNDERGROUND UTILITIES PRIOR TO CONSTRUCTION.

DATUM BASED ON TEXAS STATE PLANE COORDINATES SYSTEM, NAD 83 NORTH CENTRAL ZONE, NAVD 88, DERIVED FROM GPS OBSERVATIONS.

TITLE INFORMATION PROVIDED BY TEXAS MIDSTREAM GAS SERVICES, L.L.C.

LEGEND

TREE
MAIL BOX
SIGN
POWER POLE
GUY ANCHOR
CABLE BOX
FIRE HYDRANT
SEWER MANHOLE
DRAINAGE MANHOLE
WATER METER
GAS METER
GAS VALVE

WATER VALVE
GAS LIGHT
LIGHT POLE
POWER LINE
GAS LINE
TELEPHONE LINE
STORM SEWER LINE
SANITARY SEWER LINE
WATER LINE
FENCE LINE
TREE LINE
WELL
TEST LOCATION

EXISTING UTILITIES ARE SHOWN IN APPROXIMATE LOCATIONS GENERATED FROM PREVIOUS MAPS AND SURVEY. CONTRACTOR SHALL VERIFY EXACT LOCATION AND ELEVATION OF ALL EXISTING UTILITIES IN AREA OF WORK PRIOR TO CONSTRUCTION AND CALL TEXAS ONE CALL SYSTEM AT 1-800-245-4645 AND ALL OTHER UTILITY COMPANIES AT LEAST 2 WORKING DAYS (48 HOURS) PRIOR TO CONSTRUCTION.


TEXAS ONE CALL SYSTEM


FIELD NOTES


STA. TO STA. BOOK NO. PAGE


0+00 - 6+15 1296001-B 60 - 63 1

6+15 - 31+17 1

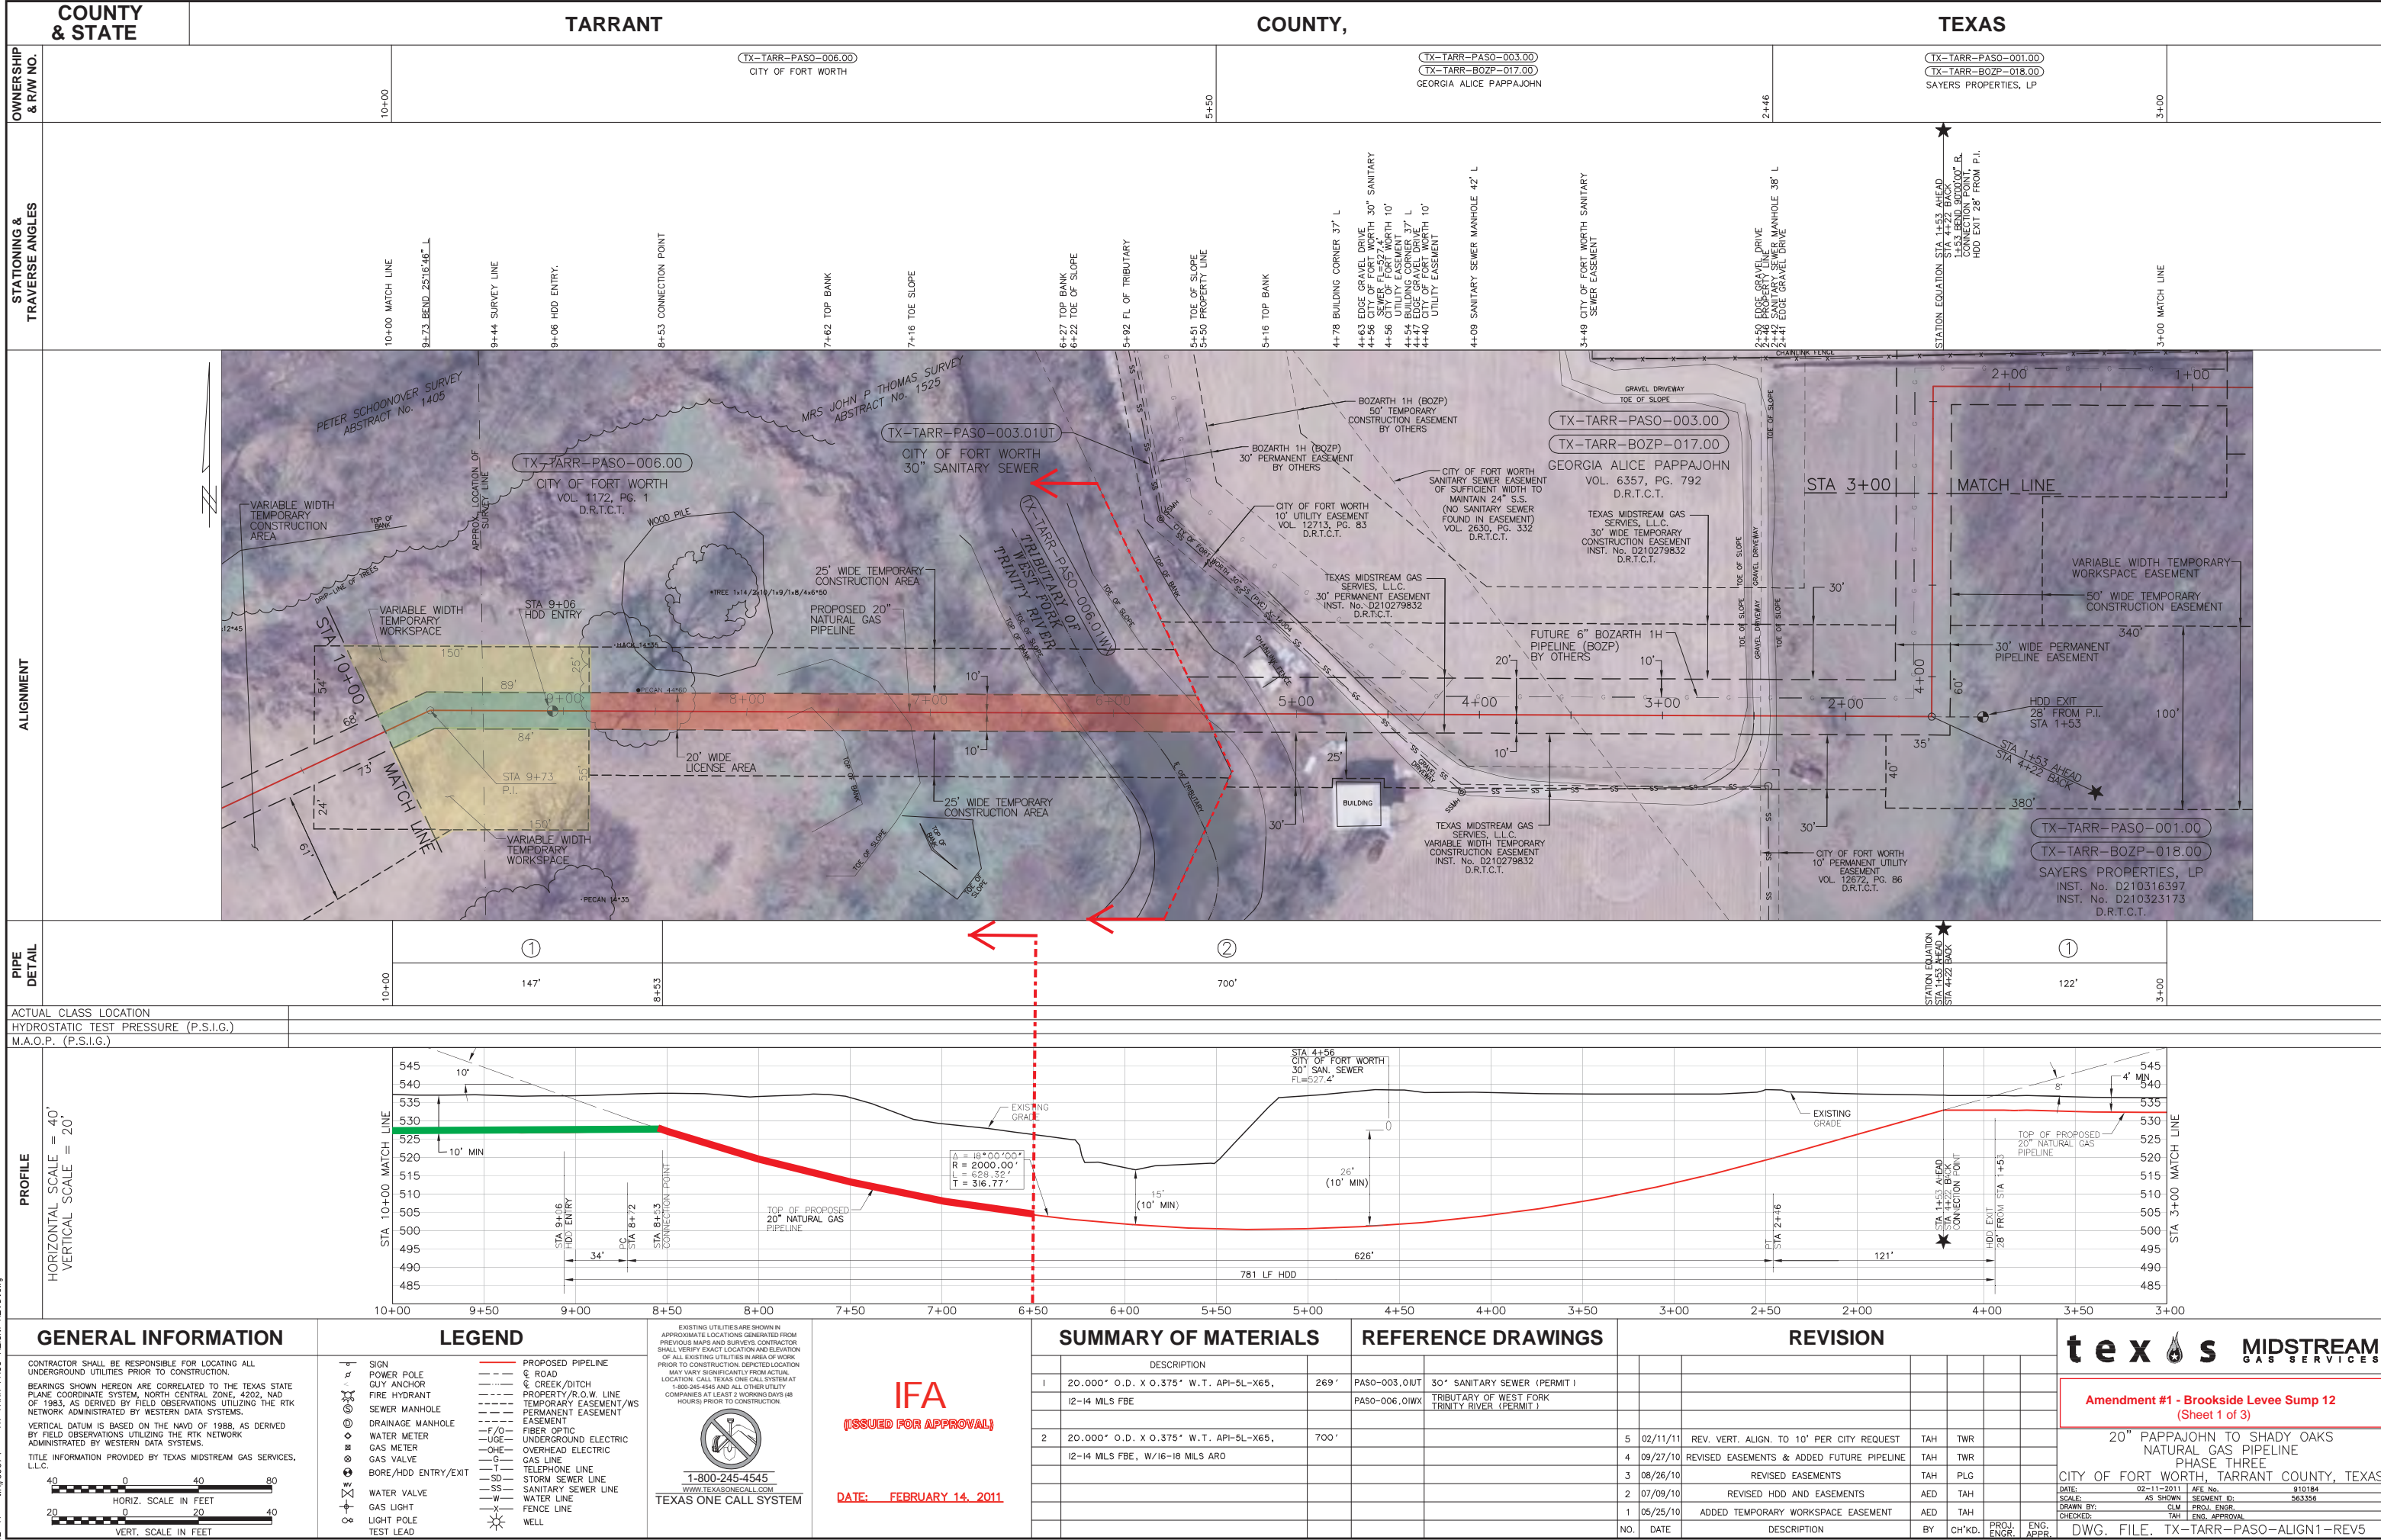

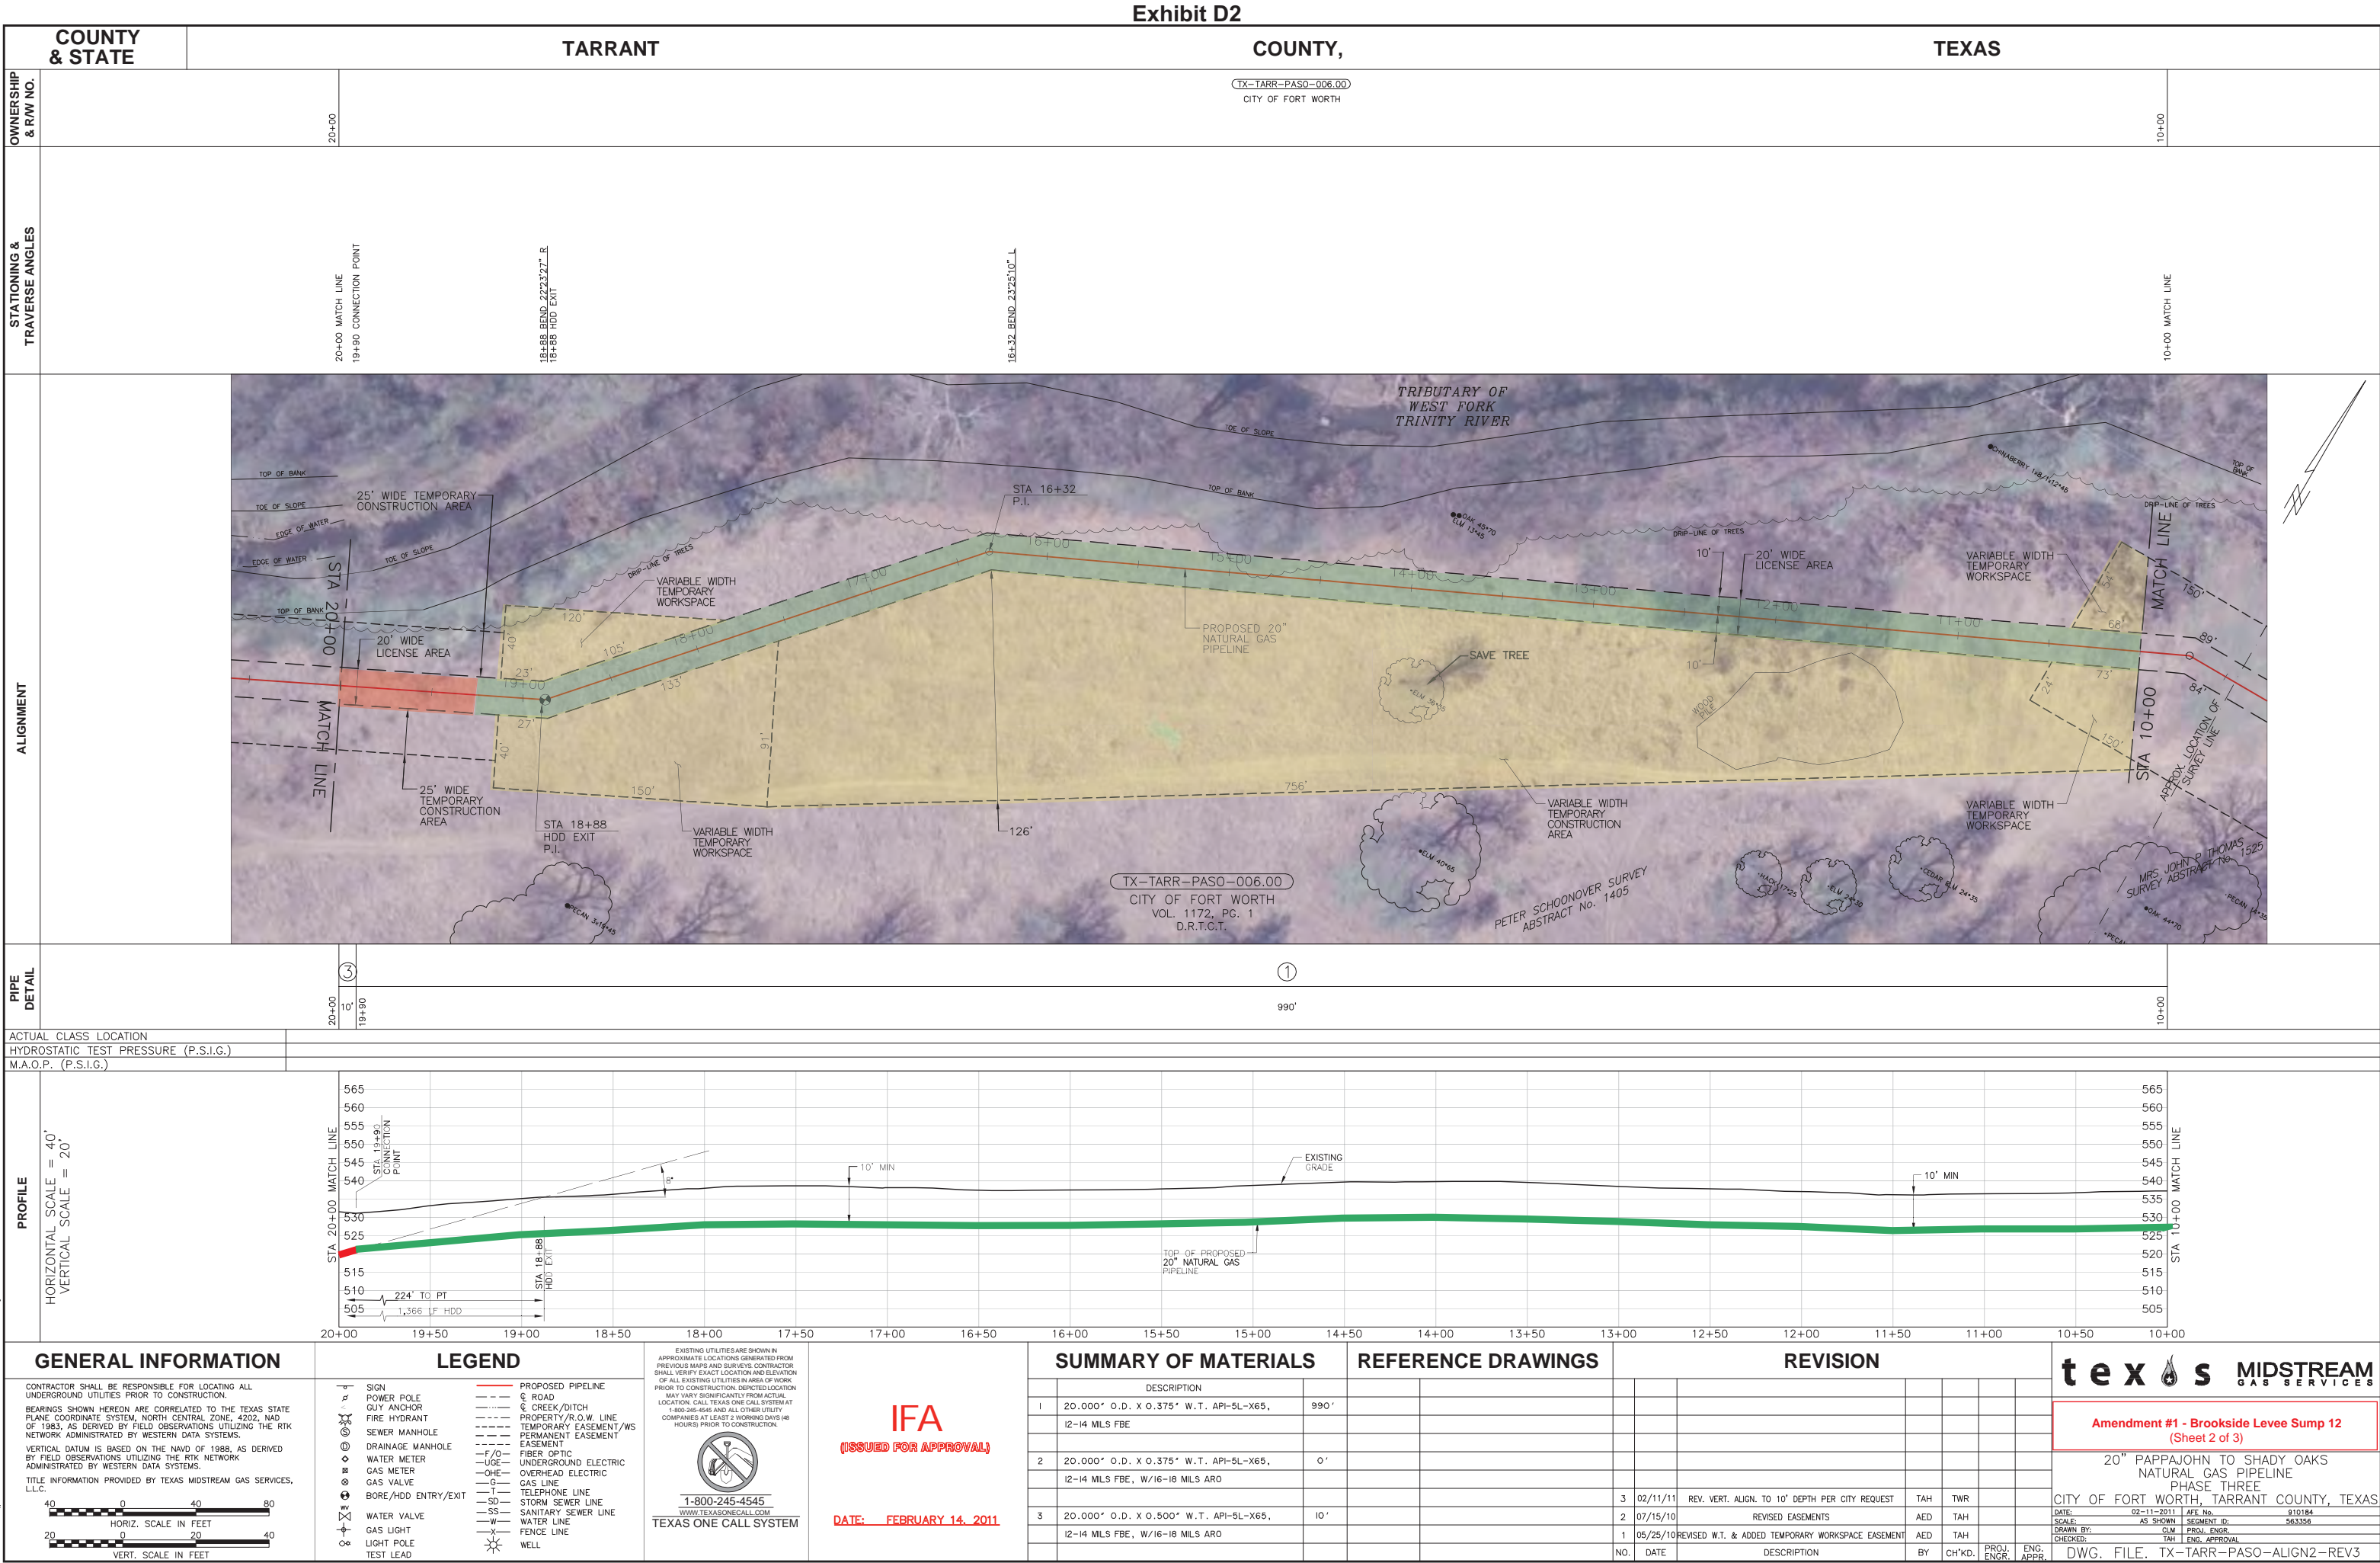

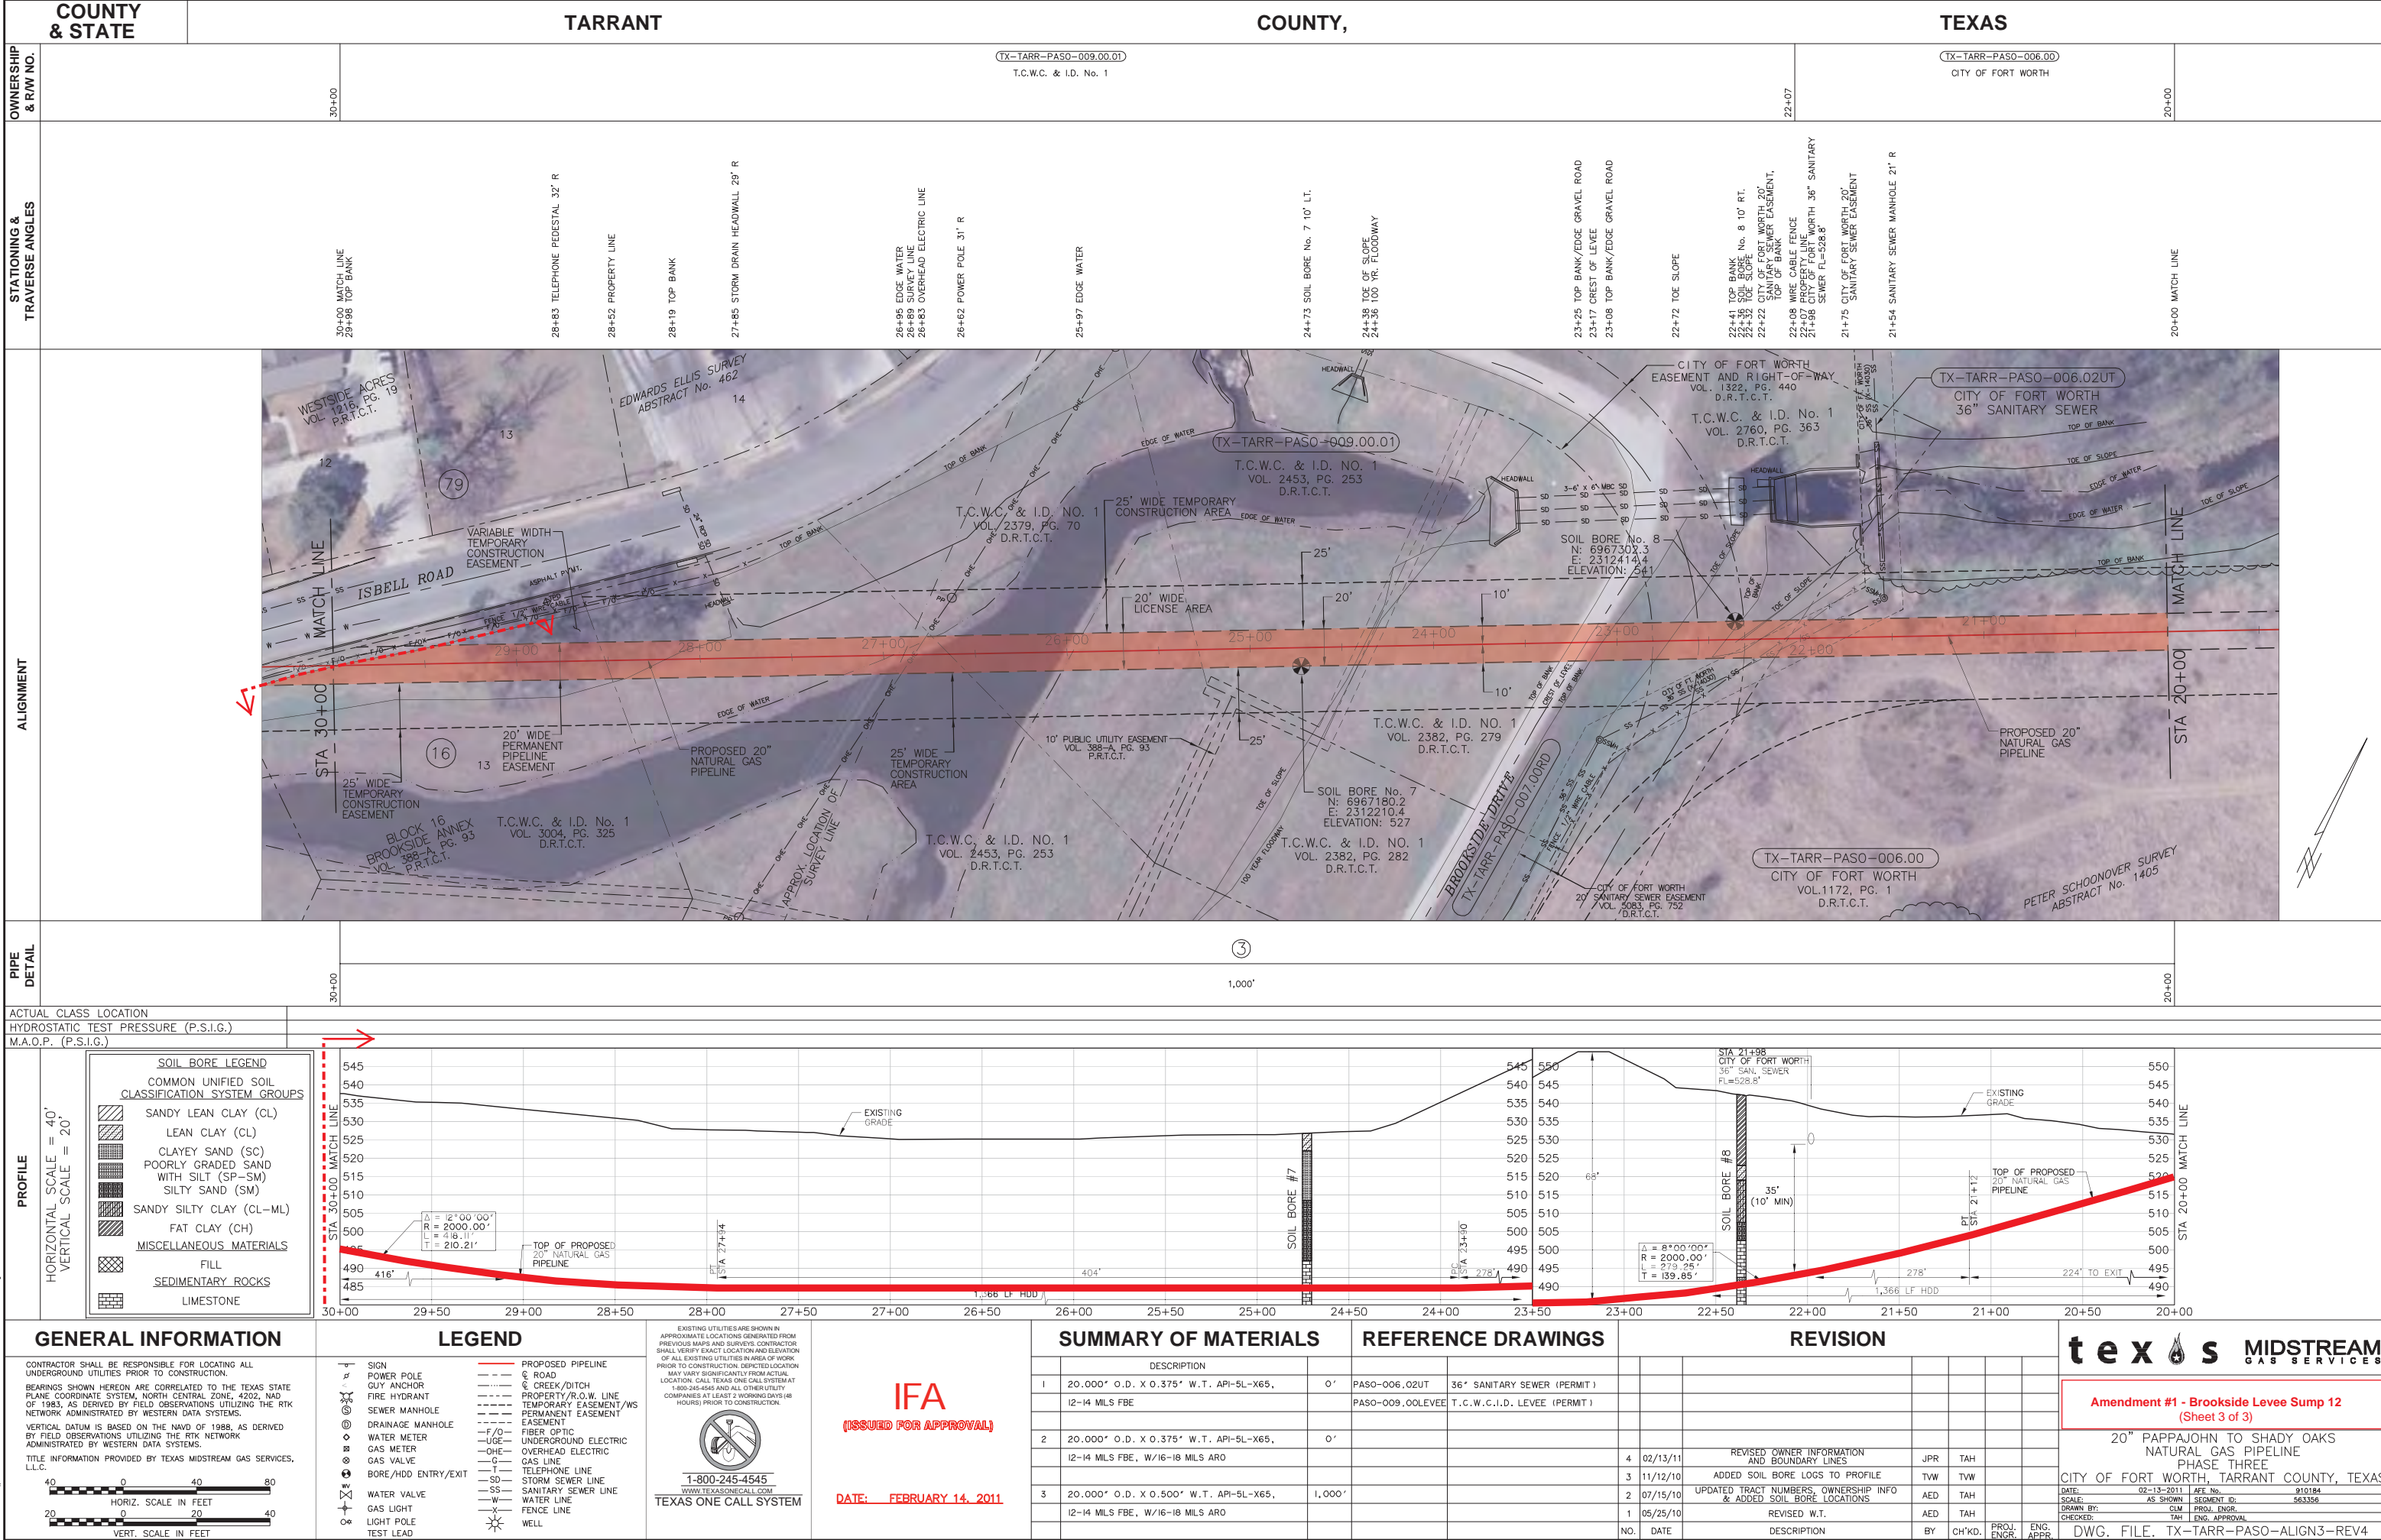

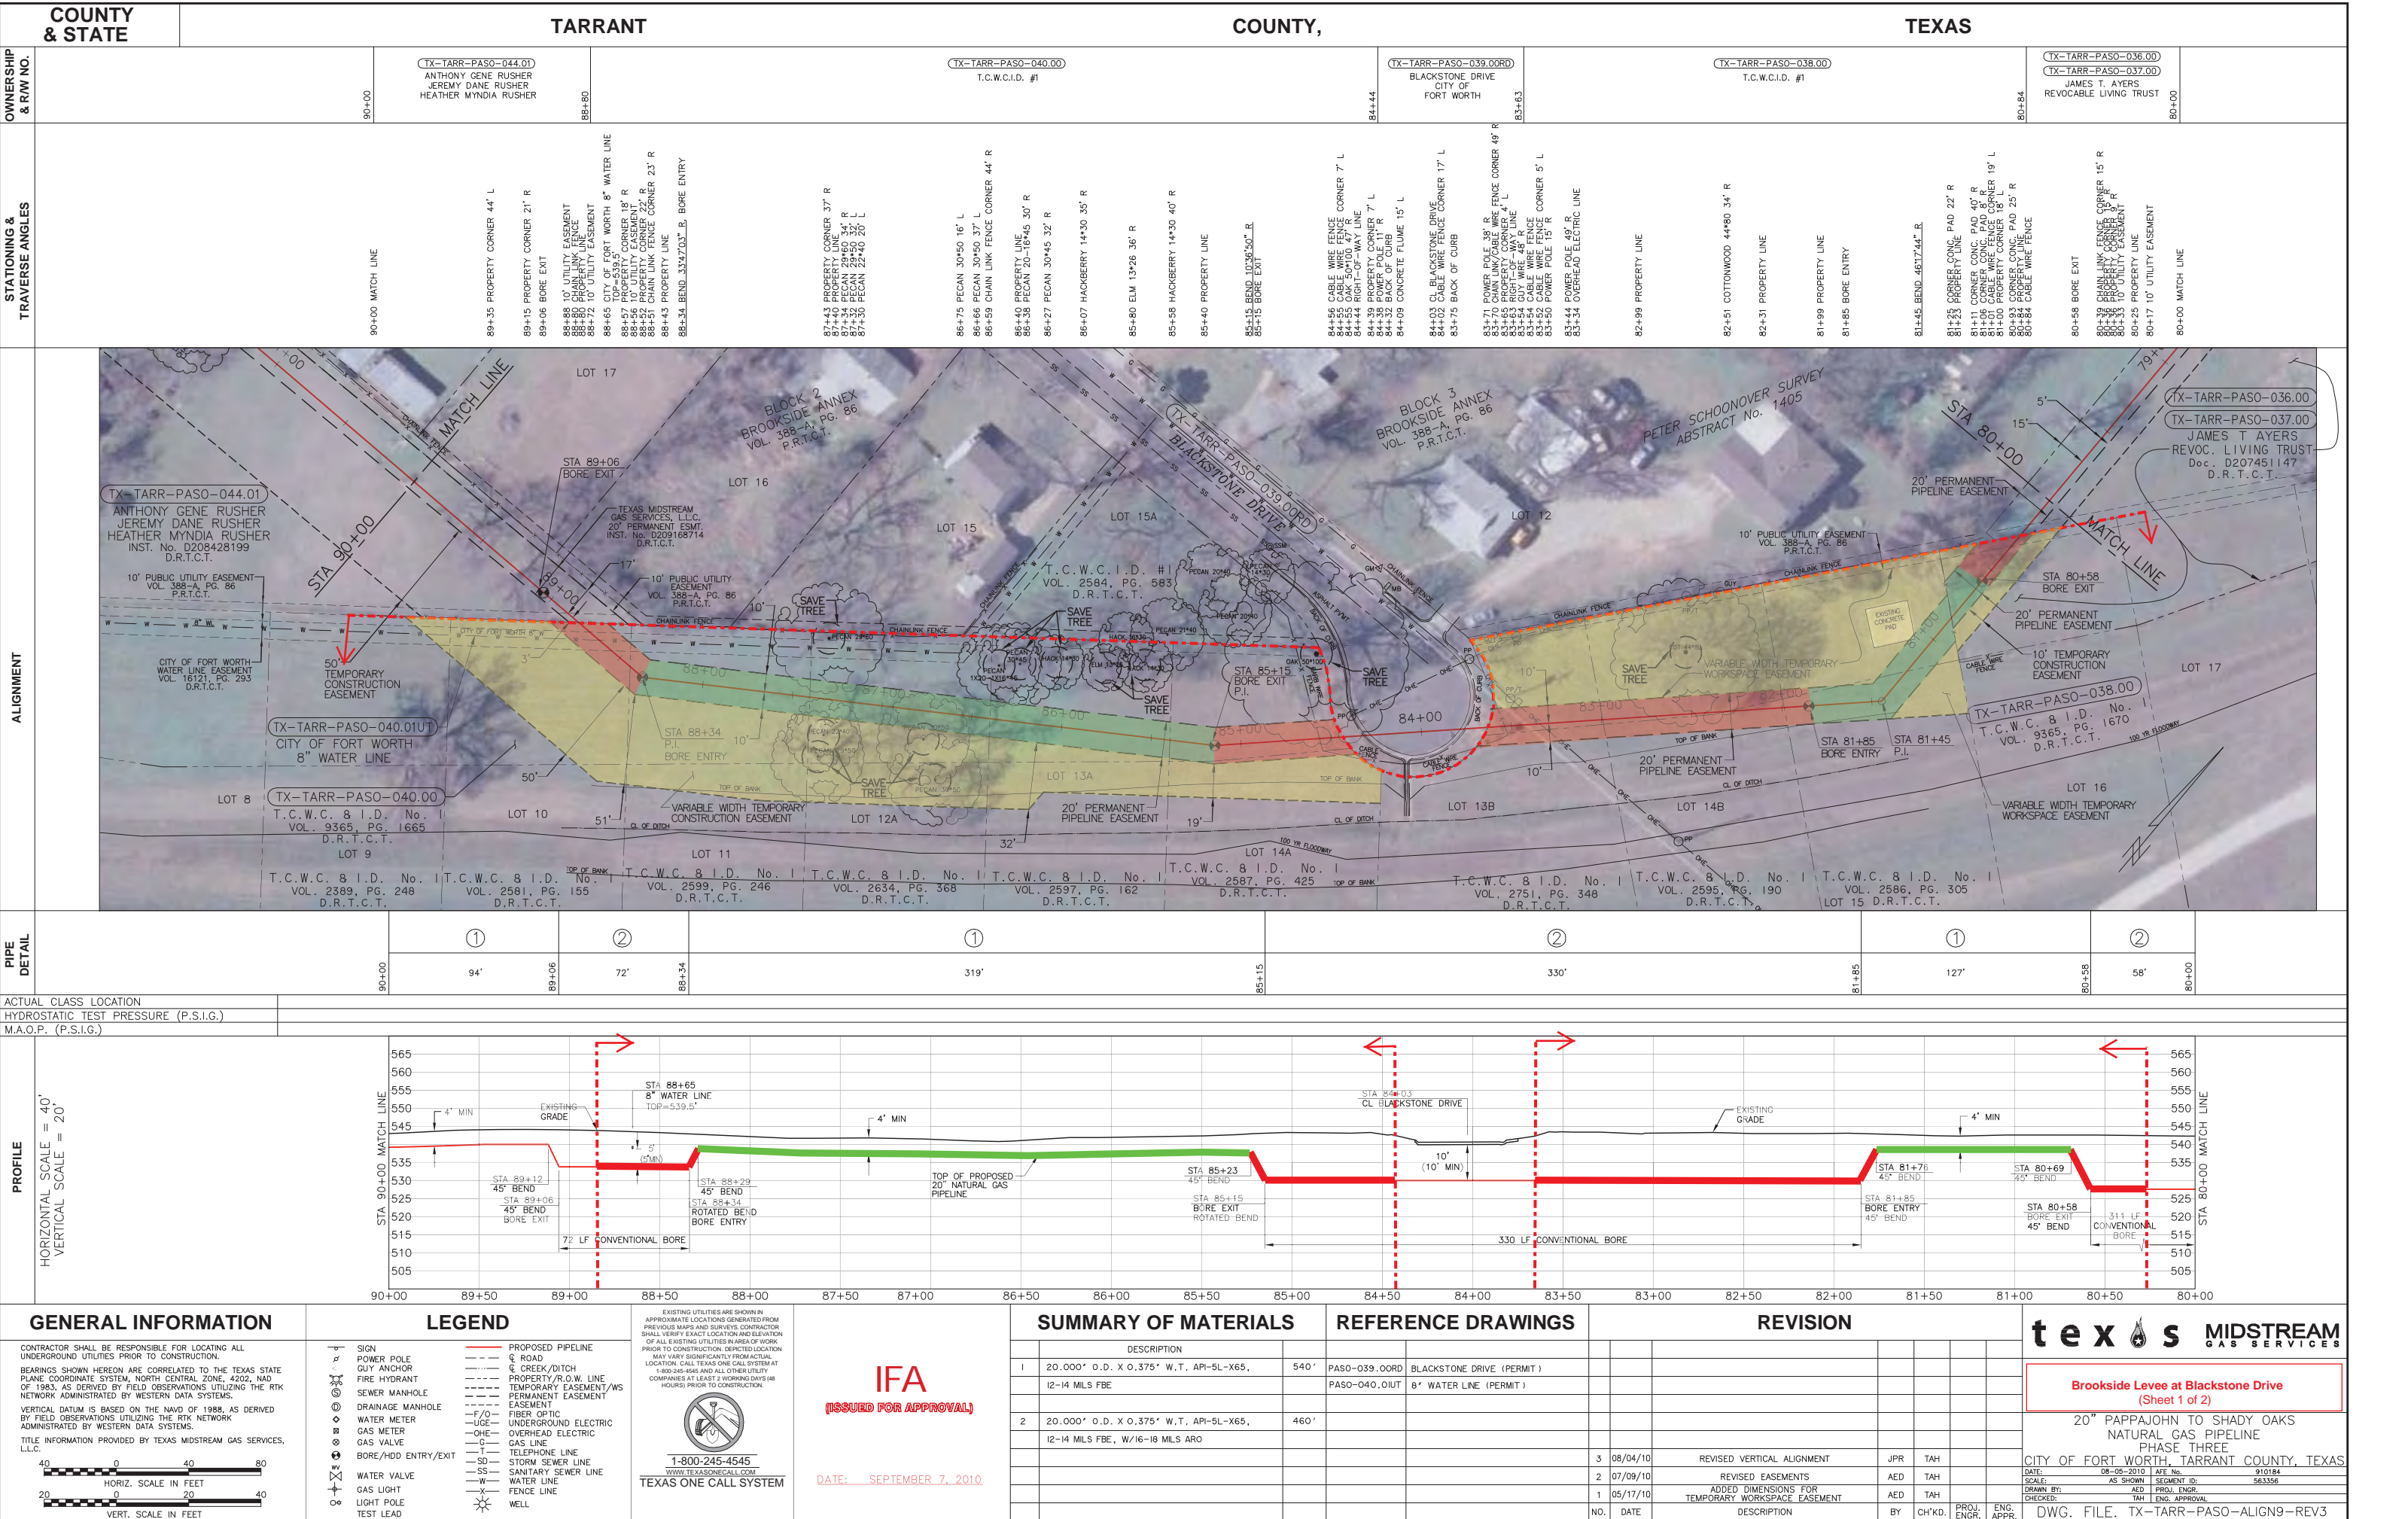




t e x



s

MIDSTREAM

GAS SERVICES

Amendment #1

Brookside Levee between Isbell and Church Hill

(Sheet 2 of 2)

20" PAPPALJOHN TO SHADY OAKS

NATURAL GAS PIPELINE

PHASE THREE

CITY OF FORT WORTH, TARRANT COUNTY, TEXAS

DATE:	09-06-2010	AFE NO.:	910184
SCALE:	AS SHOWN	SEGMENT ID:	563356
DRAWN BY:	CJM	PROJ. ENGR.	
CHECKED:	TAH	ENG. APPROVAL	

DWG. FILE: TX-TARR-PASO-ALIGN13-REV3

